


KEY PLAN:

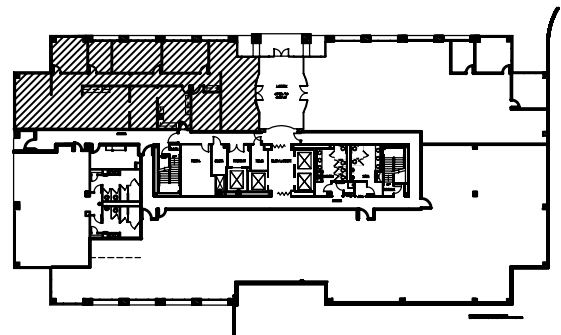

1
AB-LL

AS-BUILT
CONDITIONS

SCALE: NT6

architecture
interior design
space planning

SWI
SCHNEIDERWRIGHT INC.

2325 Lakeview Parkway / Suite 125 / Alpharetta, Georgia 30004
678.339.0031 / 678.339.0032 Fax

AS-BUILT CONDITIONS

Suite LL1000
TownPark Ravine Two
Taylor & Mathis

This drawing is the property of Schneider Wright Inc. and is not to be reproduced or copied in whole or in part or used in any way without the written permission of Schneider Wright Inc.

drawing no.	date
99072	12/06/05
drawn by	checked by
BK	
sheet description	

AS-BUILT
CONDITIONS

AB-LL